



PART PLAN
1/2" = 1'-0"

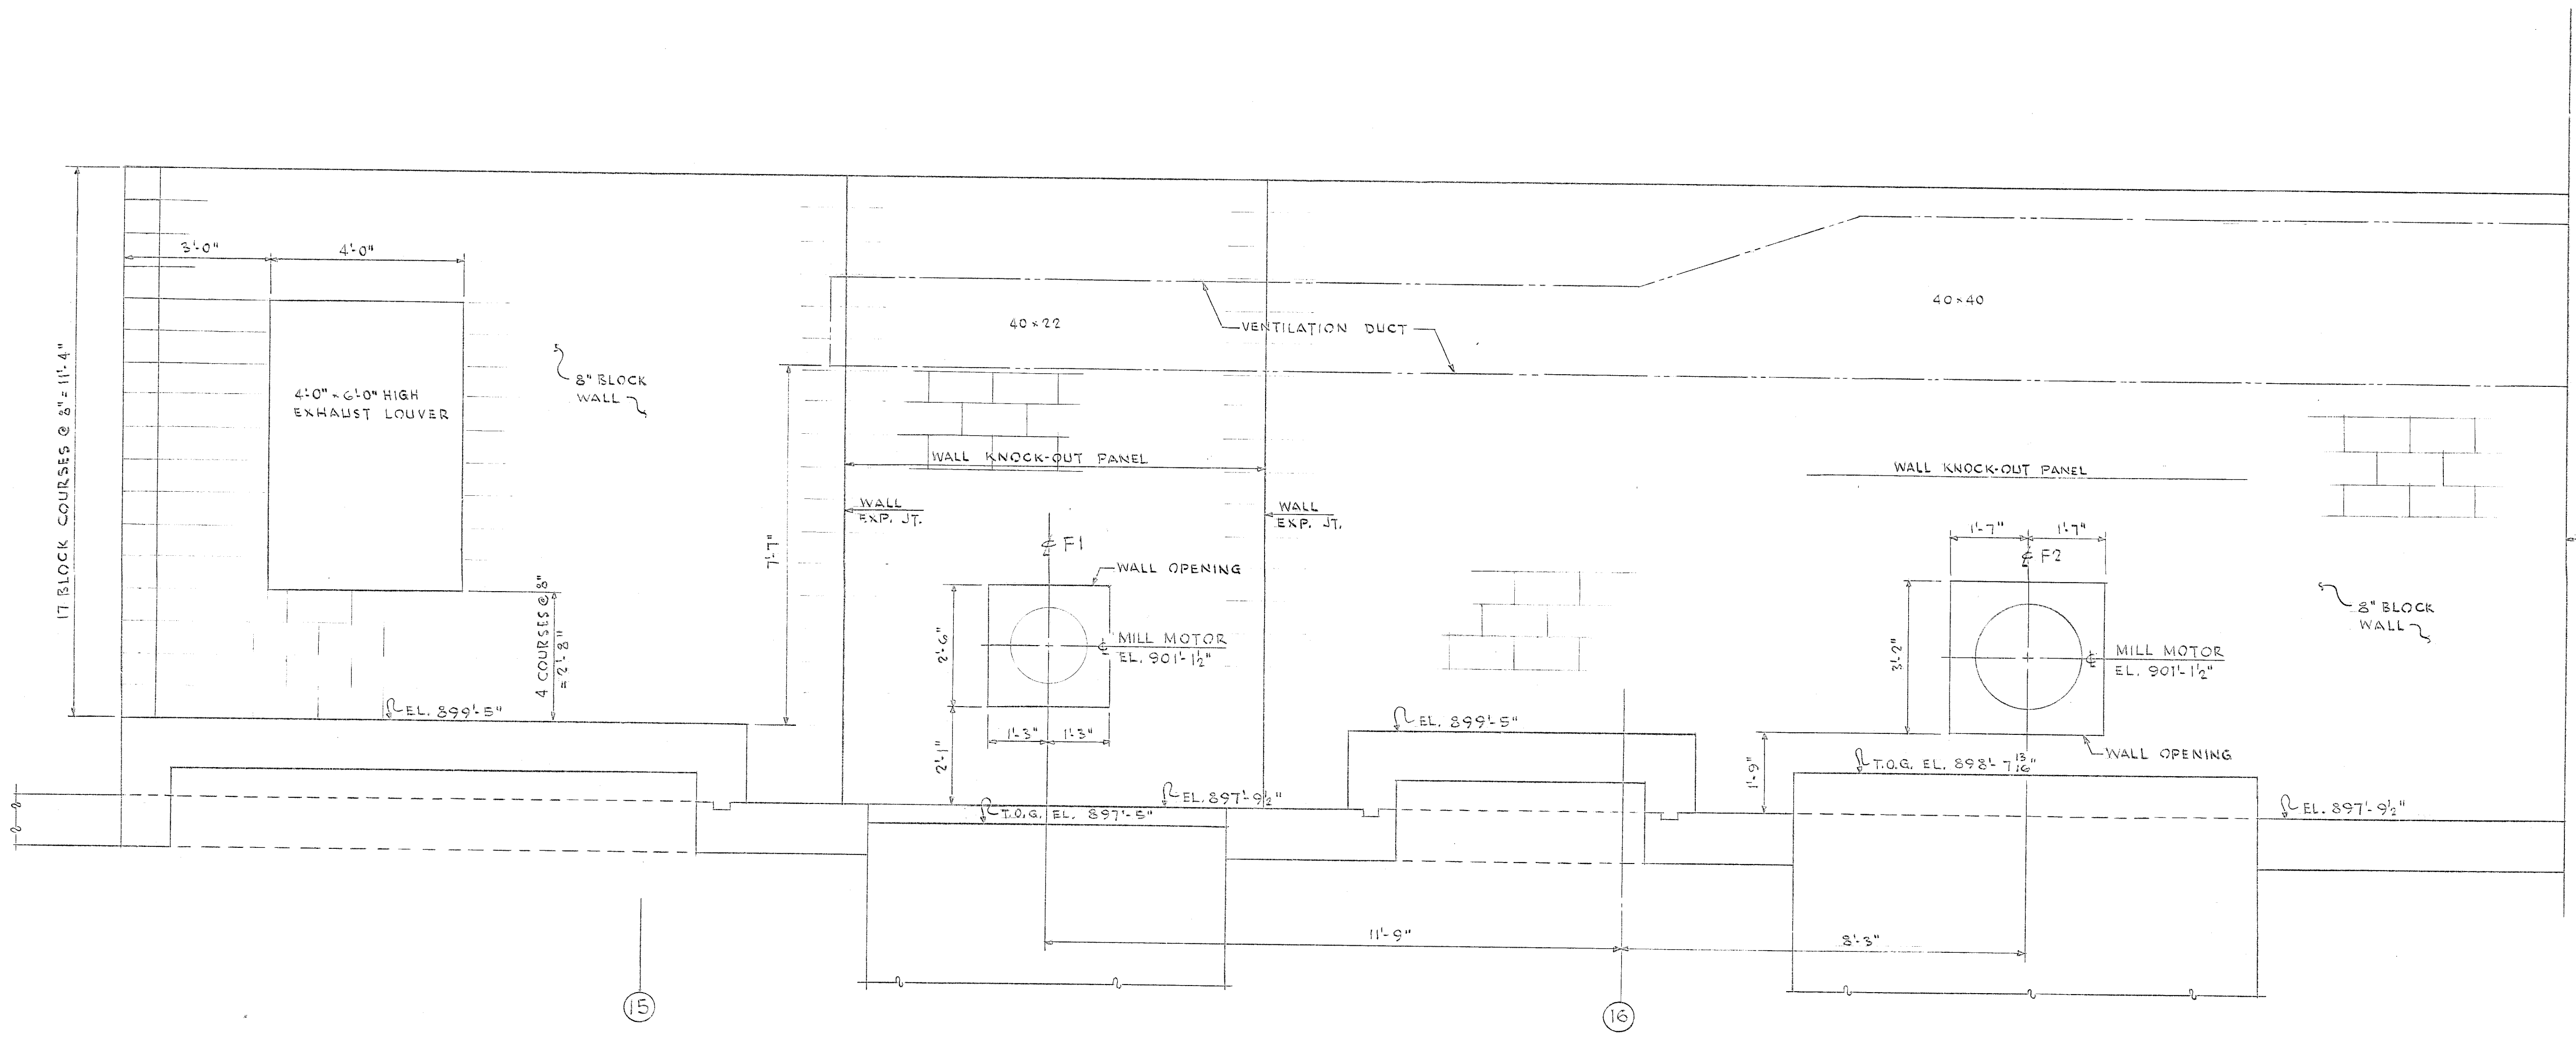

ELEVATION A-A
1/2" = 1'-0"

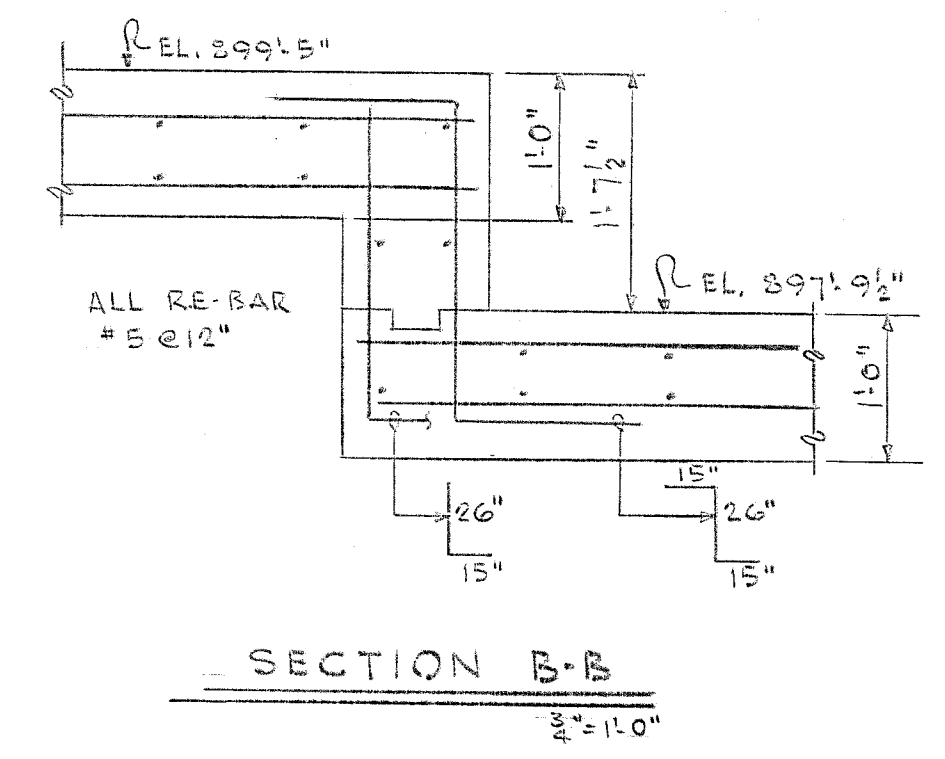

SECTION B-B
3/8" = 1'-0"

NO.	REVISION	BY	DATE
2	ADDED AS BUILT WALL DETAILS	J.H.	9-20-83
1	ADDED WALL DETAILS	J.H.	9-24-83

DEPT. #2 CONTINUOUS FINISHING MILLS
EQUIP. MOTOR ROOM
PART PLAN & ELEVATION
DETAIL OF NORTH WALL - SHEET 1

STEEL OF WEST VIRGINIA
HUNTINGTON, WEST VIRGINIA

SCALE AS NOTED	EQUIPMENT NO.
DATE 8-29-83	D-1930
DRAWN BY J. HICKS	
APPROVED BY	

WORK THIS SHEET WITH D-1920, D-1921 & D-1931